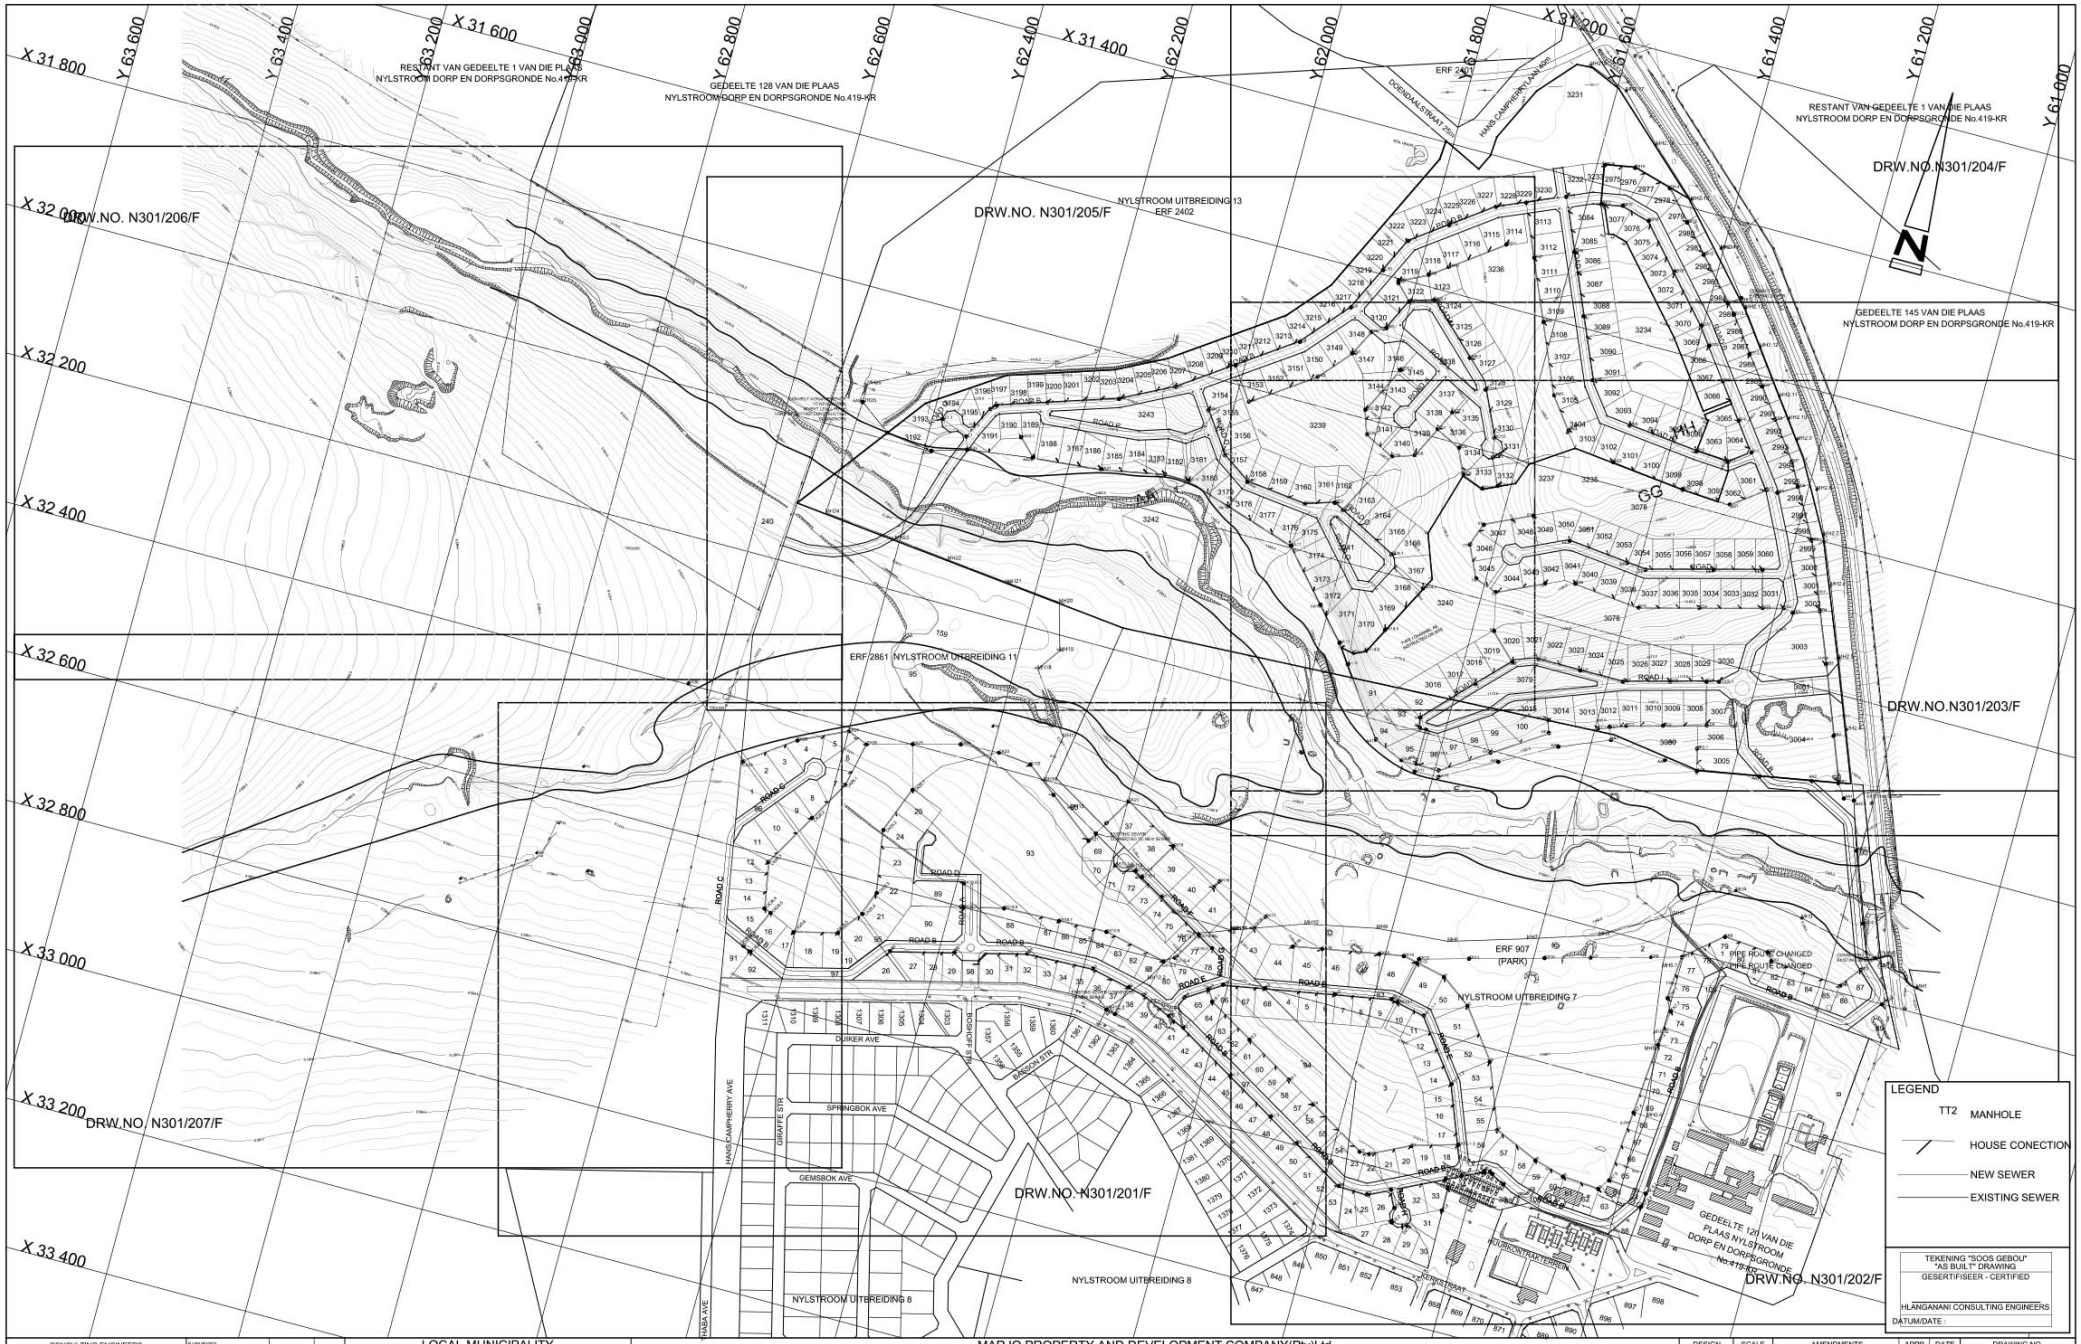

CONSULTING ENGINEERS

F:\n301200\Hlanganani-b.JPG

PRETORIA
P.O. Box 34484
Menlo Park, 0102
TEL: (012) 346 3670
FAX: (012) 346 3610

JOHANNESBURG
P.O. Box 913
BASSONIA, 1637
TEL: (011) 640 6200
FAX: (011) 640 6204

SURVEYED			
DESIGNED	DF		
DRAWN	PH		
CHECKED	BJD		
SERVICES CHECKED			
GEOTECHNICAL INVESTIGATION			
SERVITUDES			
APPROVED			

PR. ENG. NO. 970270 NOVEMBER 2009

PROJECT NO.	DRAWING NO.	FILE NO.
N301	N301/200/F	N301L200F

LOCAL MUNICIPALITY

MODIMOLLE MUNICIPALITY
PRIVATE BAG X1008
NYLSTROOM
0510

TEL : (014) 717-5211
FAX : (014) 717-4077

MARJO PROPERTY AND DEVELOPMENT COMPANY(Pty)Ltd

KORO CREEK GOLF ESTATE:
COMBINED AS - BUILT PHASE 1, 2 AND 3
GENERAL SEWER LAYOUT PLAN

DESIGN MANAGER

DATE

SCALE 1 : 2500

	AMENDMENTS	APPR.	DATE
1	AS-BUILT	DF	NOV

DRAWING NO. N301/200/F

ISSUED FOR: AS-BUILT

FILE NO.

CONTRACT NO.