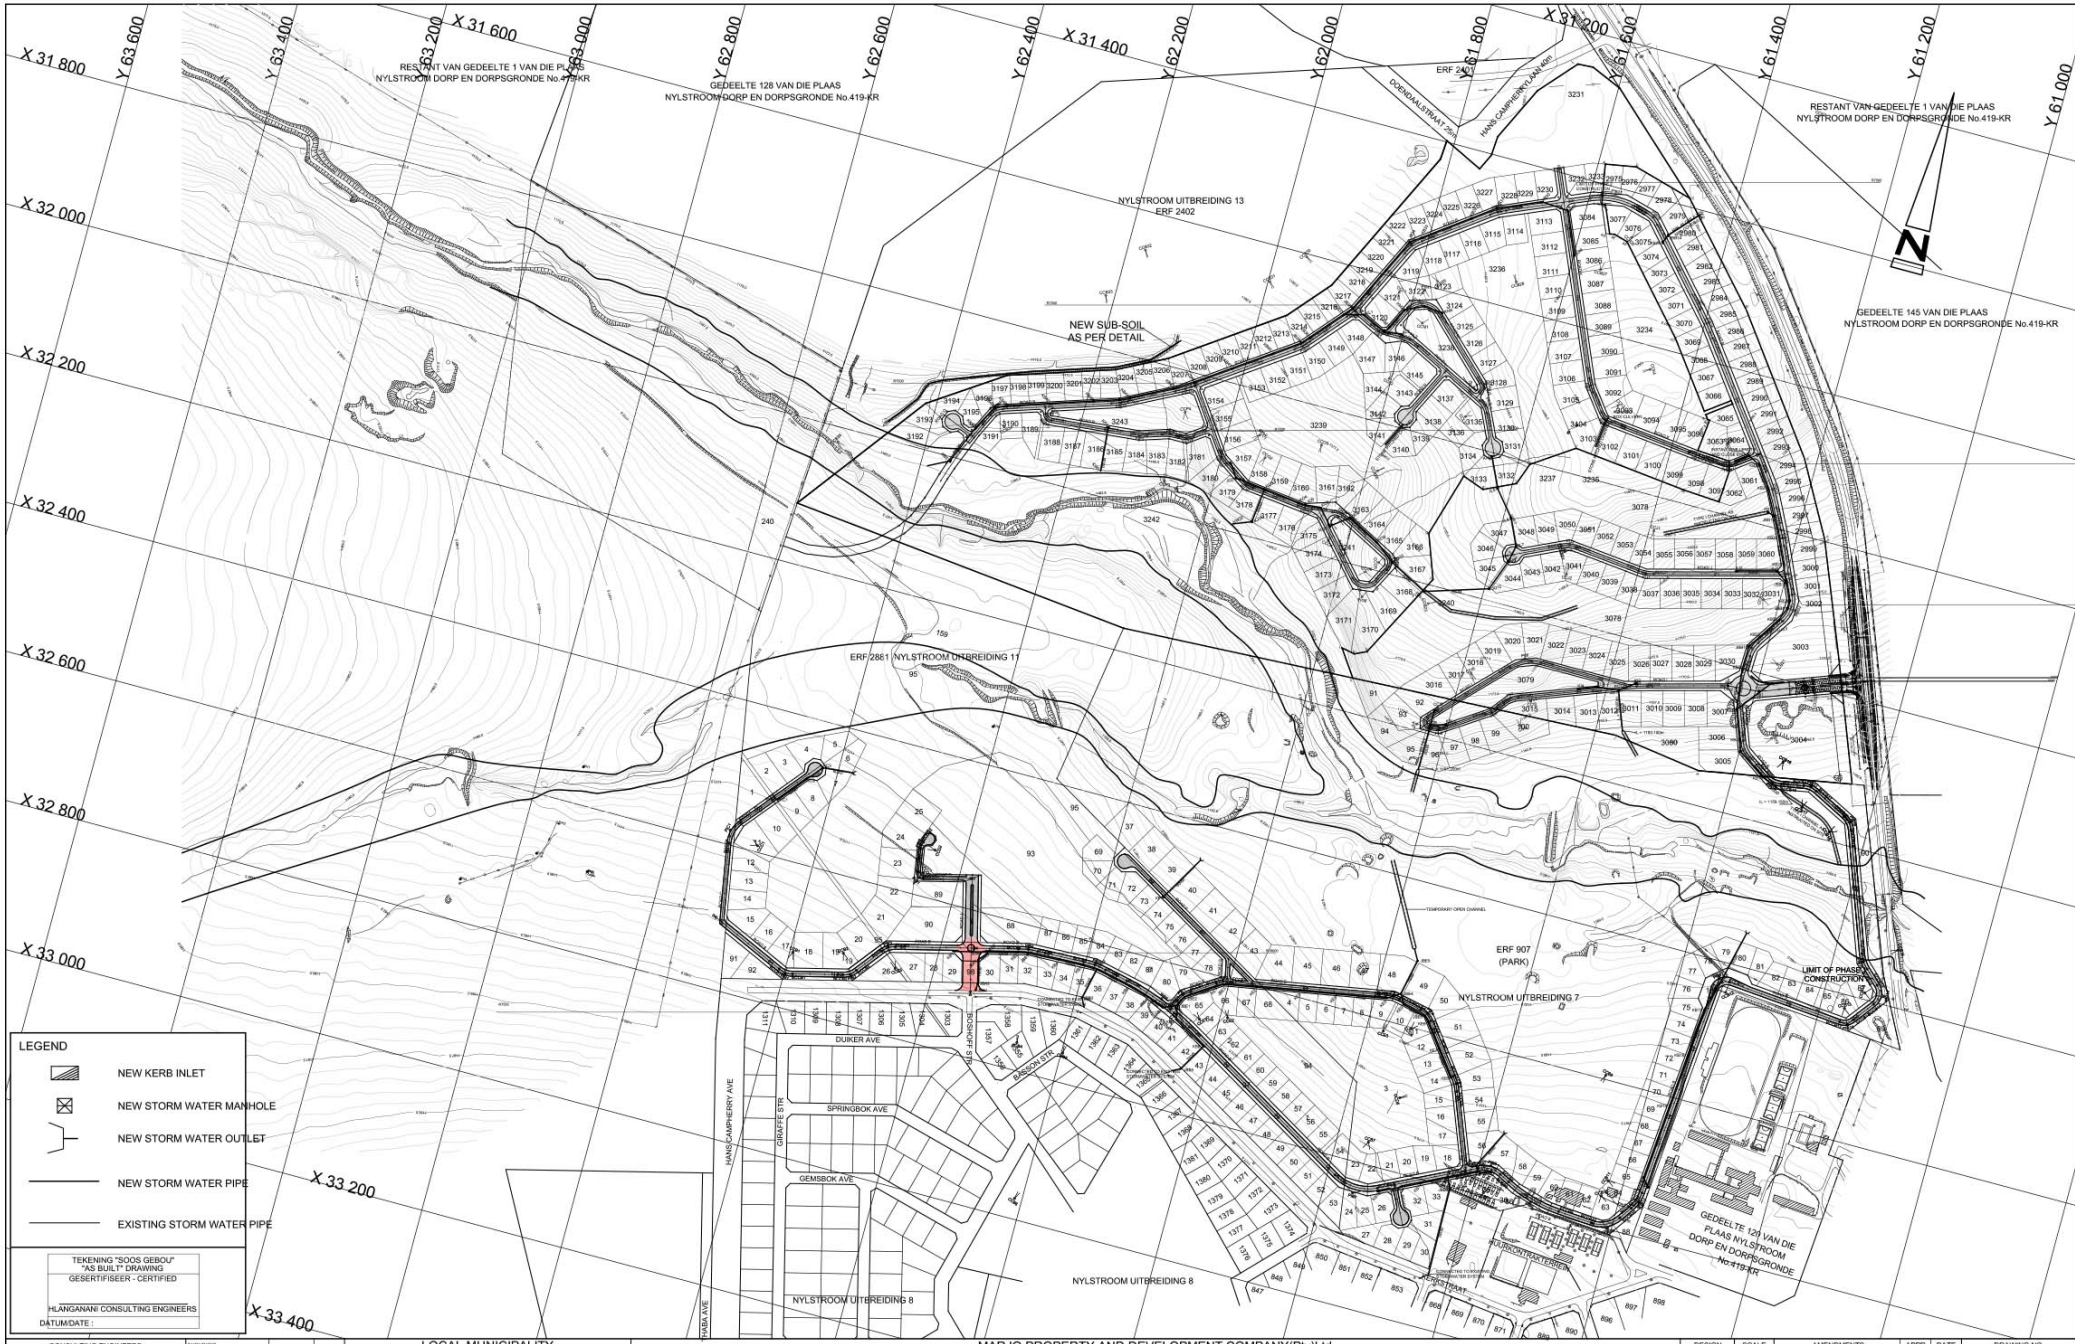

CONSULTING ENGINEERS

F:\v3\03\300\FR\signanani-b.JPG

PROJECT NO. N301 | DRAWING NO. N301/300/F | FILE NO. N301L300F

SURVEYED | DESIGNED | DRAWN | CHECKED | SERVICES CHECKED | GEOTECHNICAL INVESTIGATION | SERVITUDES | APPROVED

PR. ENG. NO. 970270 NOVEMBER 2006

LOCAL MUNICIPALITY

MODIMOLLE MUNICIPALITY
PRIVATE BAG X1008
NYLSTROOM
0510

TEL : (014) 717-5211
FAX : (014) 717-4077

MARJO PROPERTY AND DEVELOPMENT COMPANY(Pty)Ltd

KORO CREEK GOLF ESTATE:
COMBINED AS - BUILT PHASE 1, 2 AND 3
GENERAL ROADS AND STORM WATER LAYOUT PLAN

DESIGN MANAGER | DATE

SCALE 1 : 2500

AMENDMENTS	APPR	DATE

DRAWING NO. N301/300/F

REVISION: AS-BUILT

FILE NO.

CONTRACT NO.